

PLUM CREEK WATERSHED PROJECT

FLOODWATER RETARDING DAM NO. II

DRAINAGE AREA	2,470 ACRES
TOTAL STORAGE	1,420 AC. FT.
WATER SURFACE AREA	39 ACRES
HEIGHT OF DAM	29 FEET
VOLUME OF FILL	160,630 CU.YDS.

BUILT UNDER THE WATERSHED PROTECTION
AND FLOOD PREVENTION ACT

BY

HAYS-CALDWELL-TRAVIS SOIL CONSERVATION DISTRICT

AND

PLUM CREEK CONSERVATION DISTRICT

WITH THE ASSISTANCE OF

SOIL CONSERVATION SERVICE

OF THE

U. S. DEPARTMENT OF AGRICULTURE

1961

As Built Plans

Construction Completed 4-16-62

CONSTRUCTION DRAWINGS APPROVED

<i>Howard Matson</i>	6/23/61
<i>Emilee</i>	6/23/61

SEP 1 1961

FENCE LEGEND

- Existing Fences.
- Fences in sediment pool area, embankment area and 40.0' beyond toe of dam, to be removed and salvaged by land owner.
- Fences to be constructed under contract.

Emergency Spillway Diversion: 18" effective height, 3:1 side slopes, minimum base, 13'. Cost of diversion to be subsidiary to other items of work.

A minimum of 6" topsoil to be placed in Emergency Spillway and on all Compacted Fill Areas. See the specifications.

Stream Channel within embankment area to be cleared of objectional material in accordance with "Stream Channel Cleanout" of the specifications.

SD = Stub Diversion
(See Detail on Sheet No. 3.)

Fill Areas to be placed and paid for as "Compacted Fill."

On flowing side of D-9 Diversion, slope 12' bottom width of excavated chute to bottom of natural channel chute slope to be approx. 4%, 2:1 side slopes.

Fence to be offset 20' to provide area for flowage of outside water.

Fence to be aligned a minimum distance of 20' from toe of dam to facilitate ample area for flowage of outside water.

Comp. Monument
Sta. 6+47.37
El. 647.37

Pump and Pump House

Sta. 1+50 on E of Principal Spillway
Sta. 18+00 on E of Dam

Comp. Monument
Sta. 32+73.4-Dam
El. 640.66

14' Wire
Gap in 50.0
ft. of Fence


Note: Pump, Pump House and power line poles will be removed by land owner or other local interest prior to beginning of construction.

12" pipe line and valve. To be removed by Land Owner after over burden of existing Dam is removed

Farm Pond

Approximate water line

PLAN OF EMBANKMENT AND SPILLWAYS

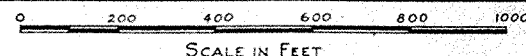


EMBANKMENT CURVE DATA

$\Delta = 29^\circ$
 $D = 14^\circ 30'$
 $R = 395.19'$
 $L = 200.0'$
P.C. = Sta. 27+47.53
P.T. = Sta. 29+47.53


EMERGENCY SPILLWAY CURVE DATA

$\Delta = 90^\circ$
 $D = 36^\circ$
 $R = 159.32'$
 $L = 250.0'$
P.C. = Sta. 5+50
P.T. = Sta. 8+00

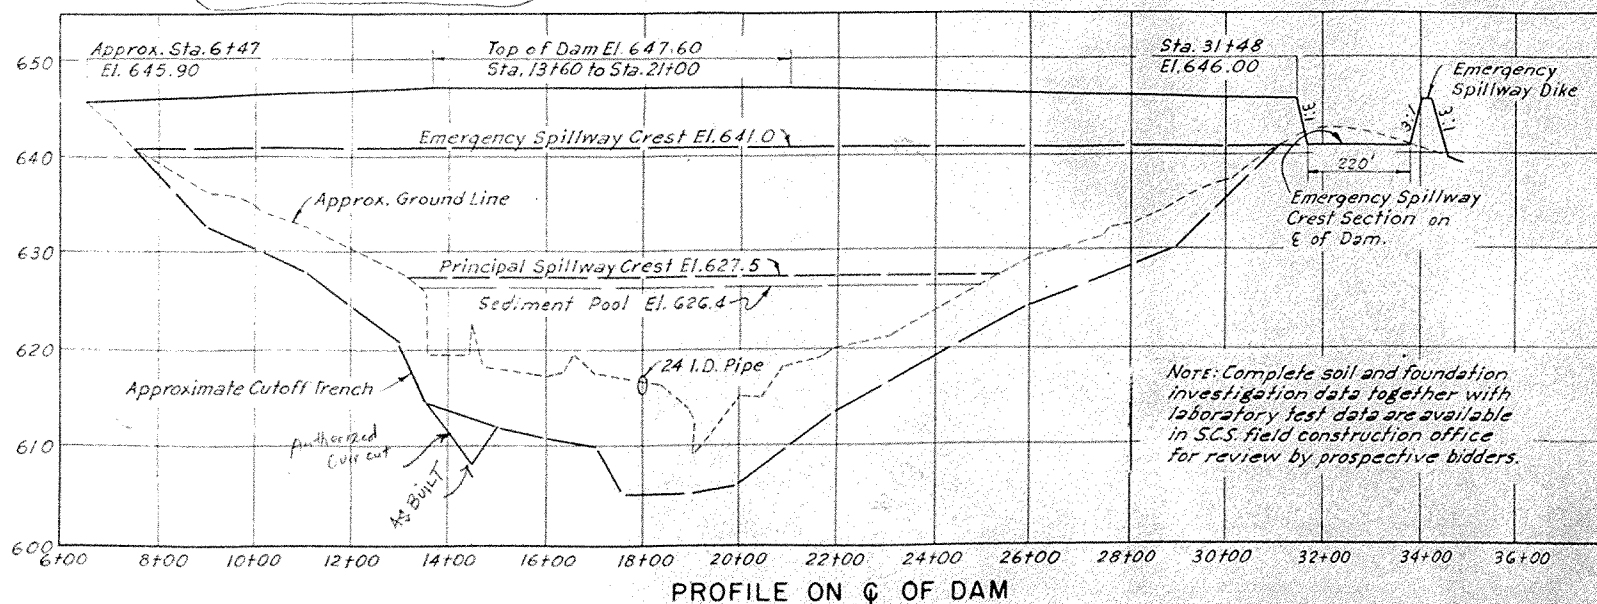


Note: Complete soil and foundation investigation data together with laboratory test data are available in SCS field construction office for review by prospective bidders.

As Built Plans
Construction Completed 4-16-62

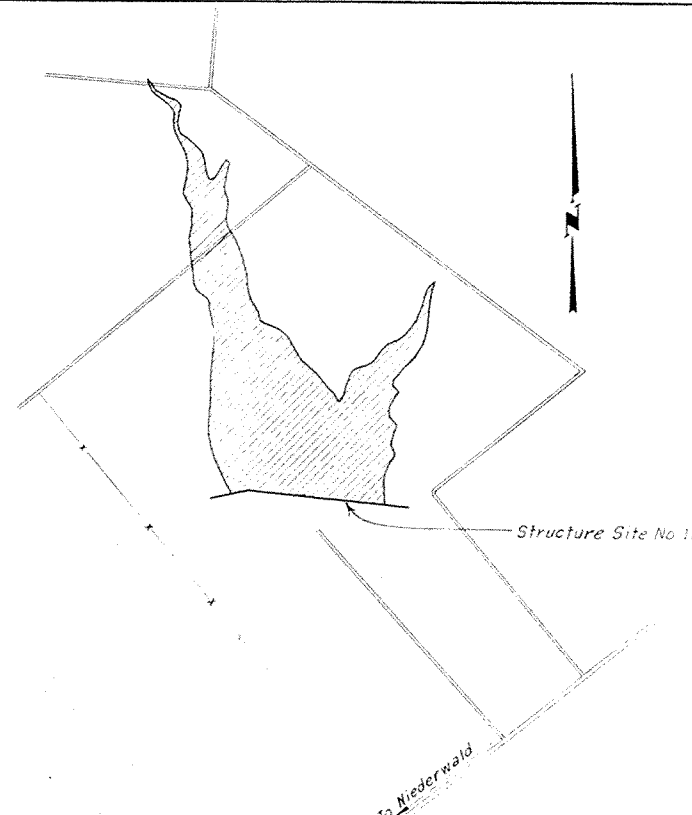

Structure Site No. 11 located approximately 5 miles northwest of Niederwald, Hays County, Texas.

VICINITY MAP

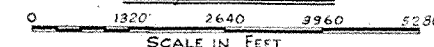

EMBANKMENT PLAN AND PROFILE
FLOODWATER RETARDING STRUCTURE SITE NO. 11
PLUM CREEK WATERSHED


HAYS, CALDWELL AND TRAVIS COUNTIES, TEXAS

U. S. DEPARTMENT OF AGRICULTURE
SOIL CONSERVATION SERVICE


Designed G.J.M.	Date 5-61	Approved by [Signature]
Drawn G.J.M. & M.G.C.	5-61	HEAD ENGINEERING & RESEARCH PLANNING DIV. FORT WORTH, TEXAS
Traced M.G.C.	5-61	STATE CONSERVATION ENGINEER S.C.S.
Checked G.J.M. & G.W.T.	5-61	Sheet 2 of 9

4-E-15,595

SEP 1 1961

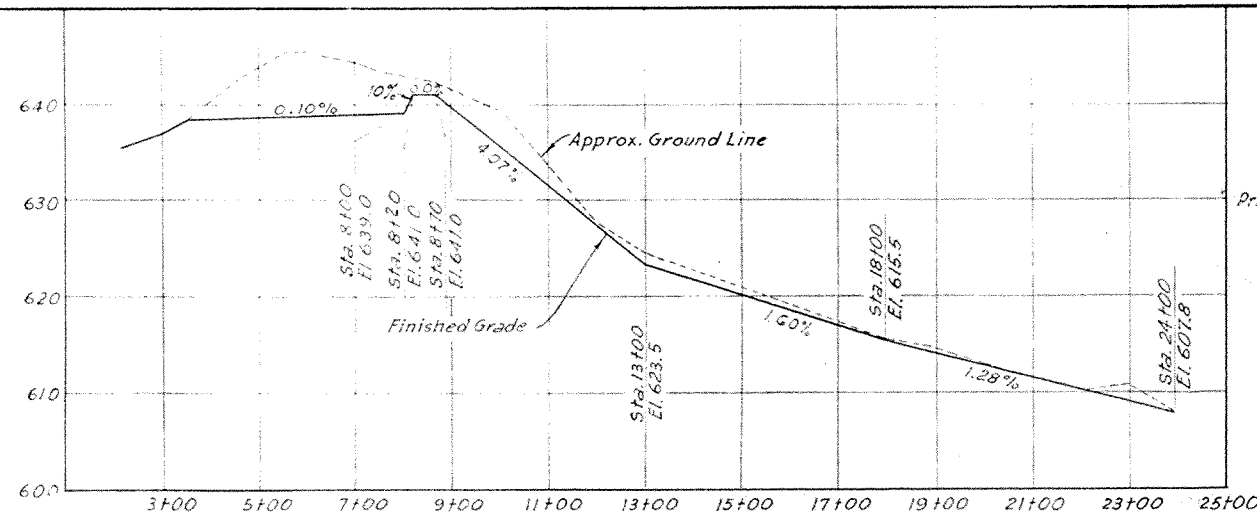


PROFILE ON C OF EMERGENCY SPILLWAY

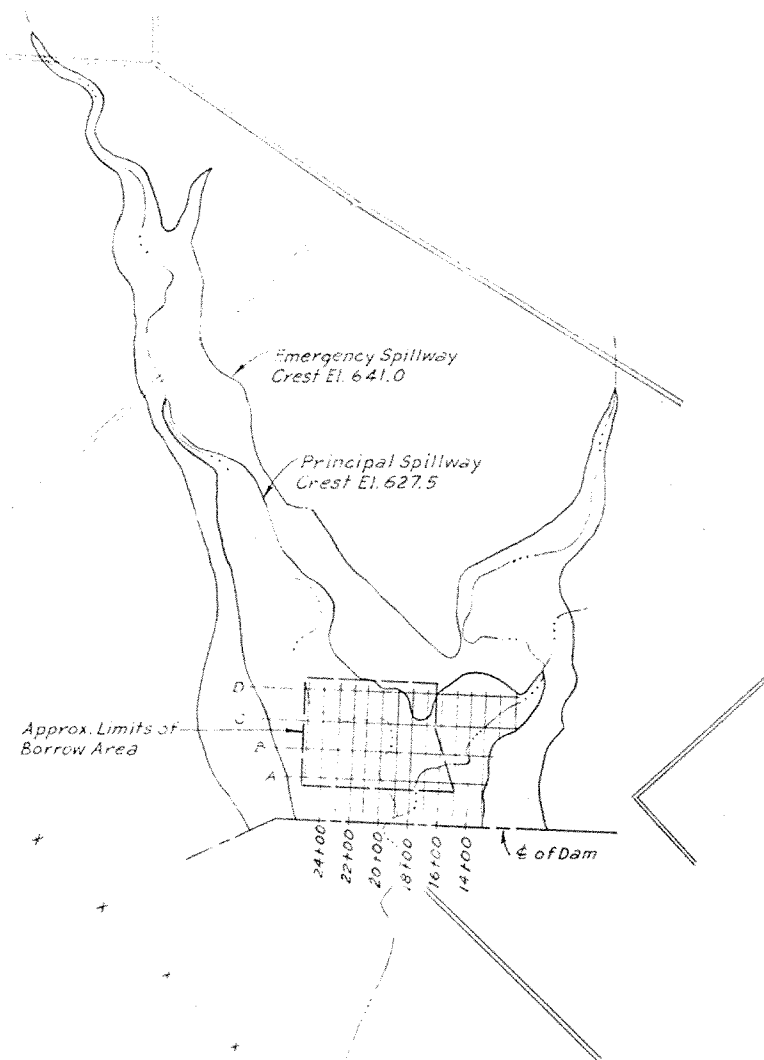

GENERAL PLAN OF RESERVOIR

0 660 1320 1980 2640
SCALE IN FEET

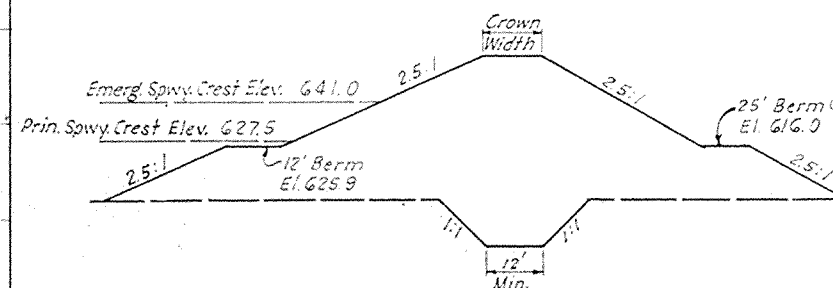

TYPICAL SECTION

NOTES:

No formal zoning of the embankment is required. The Engineer will exercise a selective placement of the materials to provide for the more plastic materials like those represented by laboratory curves Nos 1 and 5 to be placed in the cutoff trench and center core portion of the dam. The gravelly materials represented by laboratory curves Nos 2 and 4 will be selected for use in the outer shell portions of the dam. Minimum dry densities and moisture limits will be shown in Table of Materials.


If the material being placed in the fill contains 1/4 inch or larger material in amounts differing from the percentages found in the laboratory sample, the minimum dry density and moisture requirement will be corrected for this variation.

No upward limits of moisture placement are established. Upward limits of placement moisture will be determined by the Engineer during construction, on the basis of the workability aspects of the materials and densities being reached.

TABLE OF MATERIALS						
LAB TEST		COMPACTION REQUIREMENTS			Lab. Curve	
Modified		Min. Dry Density	Moisture Range			
Max Dry Den	Opt'm Moist	Lbs Per Cu Ft.	Percent		No.	
			From	To		
27.1	9.7	115	9	Up	2	
20.2	12.8	108	12	Up	4	
110.5	17.0	100	16	Up	1	
114.5	15.5	103	15	Up	5	
Like Curve No. 1					3	
Like Curve No. 5					6	
Like Curve No. 2					7	

EMBANKMENT DATA

ELEVATION	SURFACE ACRES	STORAGE	
		ACRE FEET	INCHES
612.	0	0	0
616.	5	10	.05
620.	12	44	.21
624.	26.7	121	.59
626.4	39.	200	.97
627.5	47.	247	1.20
628.	49.4	271	1.32
632.	73.	516	2.51
636.	95.	852	4.14
640.	124.	1290	6.27
641.	136.	1420	6.90
644.	166.	1873	9.10
648.	212.	2629	12.77
652.	253.6	3560	17.30
656.	314.4	4696	22.81
Top of Dam (Effective) Elev.		645.90	
Emergency Spillway Crest Elev.		641.0	
Principal Spillway Crest Elev.		627.5	
Sediment Pool Elev. @ Port Crest		626.4	
Drainage Area, Acres		2470	
Sediment Storage, Acre Feet		288	
Floodwater Storage, Acre Feet		1132	
Max. Emergency Spillway Cap., cfs		5816	

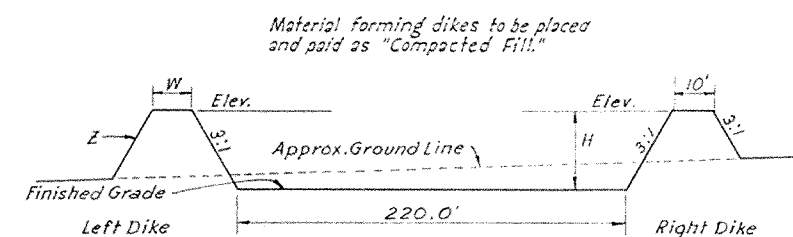


Left Dike Note:

From Sta. 8+00 to Sta. 8+70, El. 646.00, W=14.0', Z=2.5:1.
Transition from Sta. 8+70 to Sta. 9+00.
Sta. 9+00 to Sta. 12+50, W=10.0', Z=3:1, H=3.0' above grade.
From Sta. 12+50 grade dike uniformly to Sta. 14+00.
From Sta. 14+00 to Sta. 17+50, W=10.0', Z=3:1, H=3.0' above grade.
From Sta. 17+50 grade dike uniformly to H=3.5' @ Sta. 19+00.
From Sta. 19+00 to Sta. 24+00, W=10.0', Z=3:1, H=3.5' above grade.

Right Dike Note:

From approx. Sta. 6+50 to Sta. 8+70, El. 646.00.
Transition from Sta. 8+70 to Sta. 9+00.
Sta. 9+00 to Sta. 12+50, H=3.0' above grade.
From Sta. 12+50 grade dike uniformly to Sta. 14+00.
From Sta. 14+00 to Sta. 17+50, H=3.0' above grade.
From Sta. 17+50 grade dike uniformly to H=3.5' @ Sta. 19+00.
From Sta. 19+00 to Sta. 24+00, H=3.5' above grade.

TYPICAL SECTION - EMERGENCY SPILLWAY

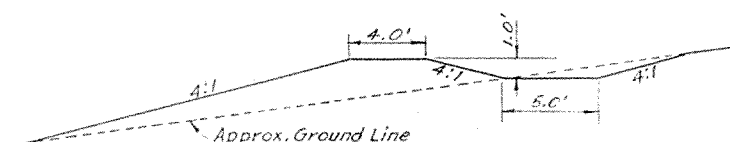

TYPICAL SECTION


STUB DIVERSIONS NO. 1 TO NO. 8

















Stub diversions will be constructed at the approximate locations shown on the Plan of Embankment and Spillways. Minimum section will be as shown above. Grade will be established by the Project Engineer. Stub diversions to be built as 'semi-compacted fill' and paid by the linear foot.

GENERAL PLAN AND PROFILE
FLOODWATER RETARDING STRUCTURE SITE NO. 11
PLUM CREEK WATERSHED
IN
HAYS, CALDWELL AND TRAVIS COUNTIES, TEXAS

U. S. DEPARTMENT OF AGRICULTURE
SOIL CONSERVATION SERVICE

Designed G.J.M.	5-61	Approved by	5-61
Drawn G.J.M. & M.G.C.	5-61	Checked by	5-61
Traced M.G.C.	5-61	Sheet	1 of 1
Checked G.J.M. & G.W.I.	5-61	Drawing No.	4-E-15,595

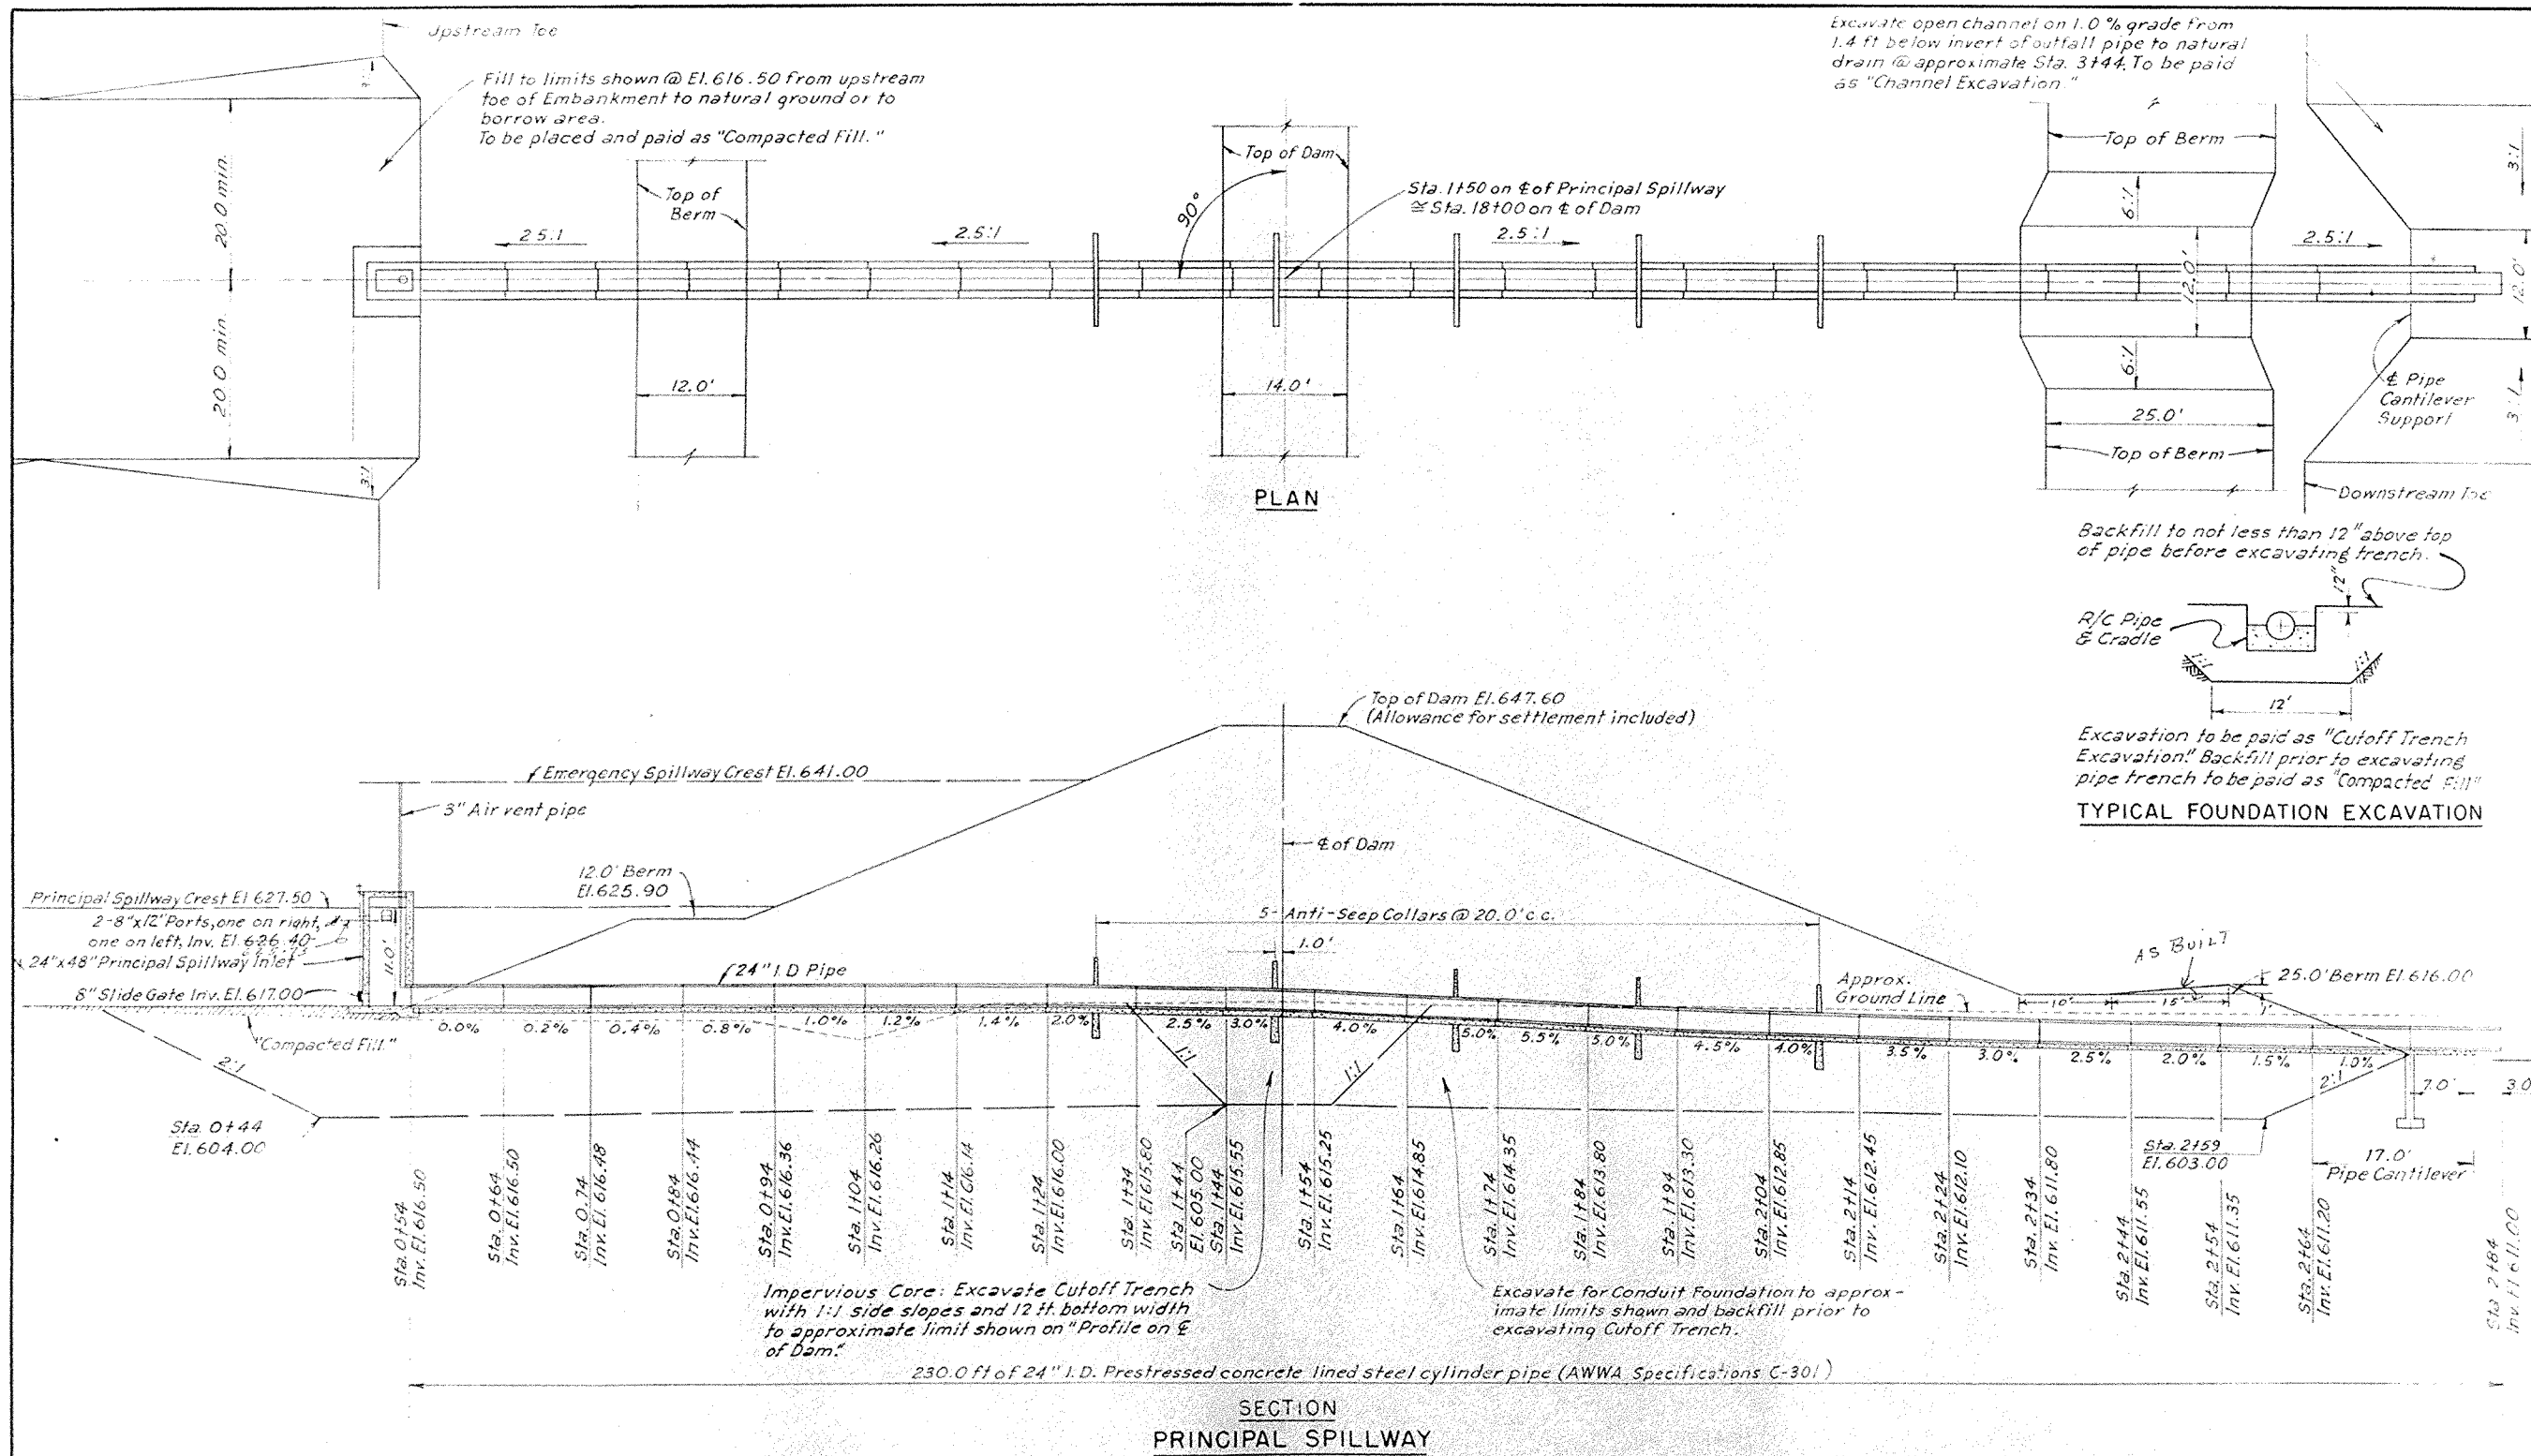

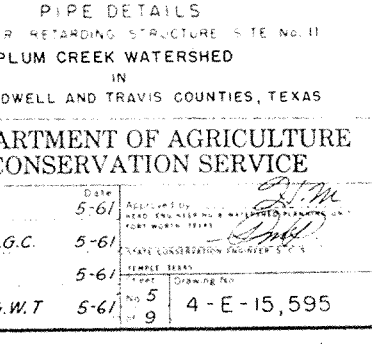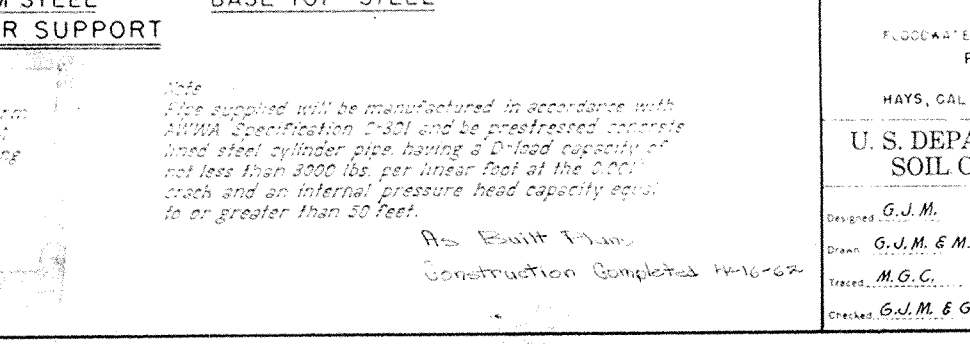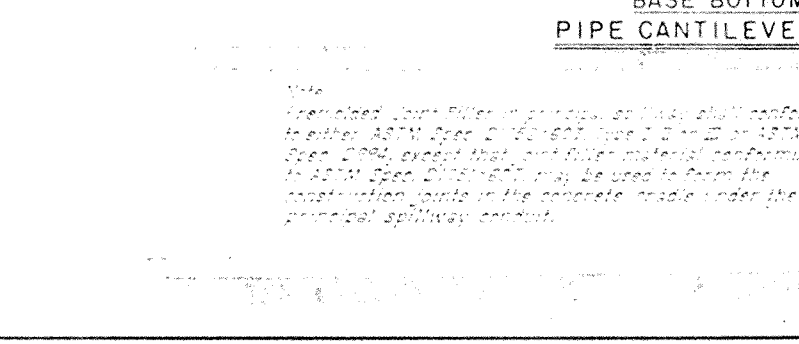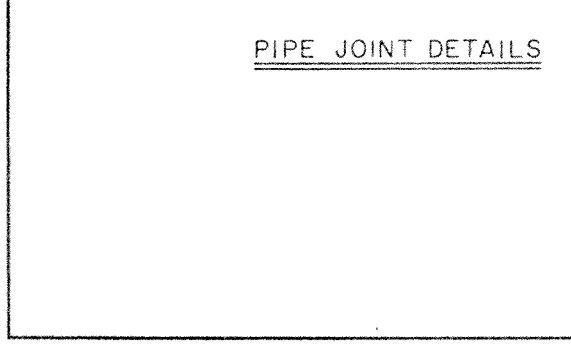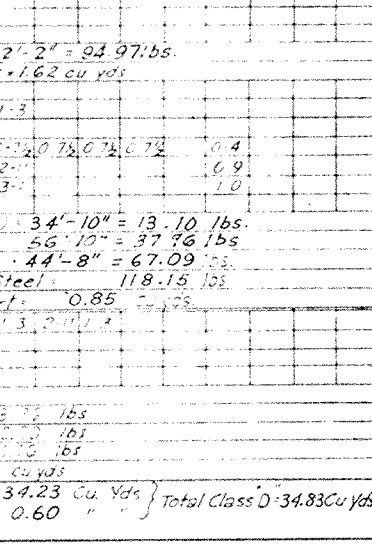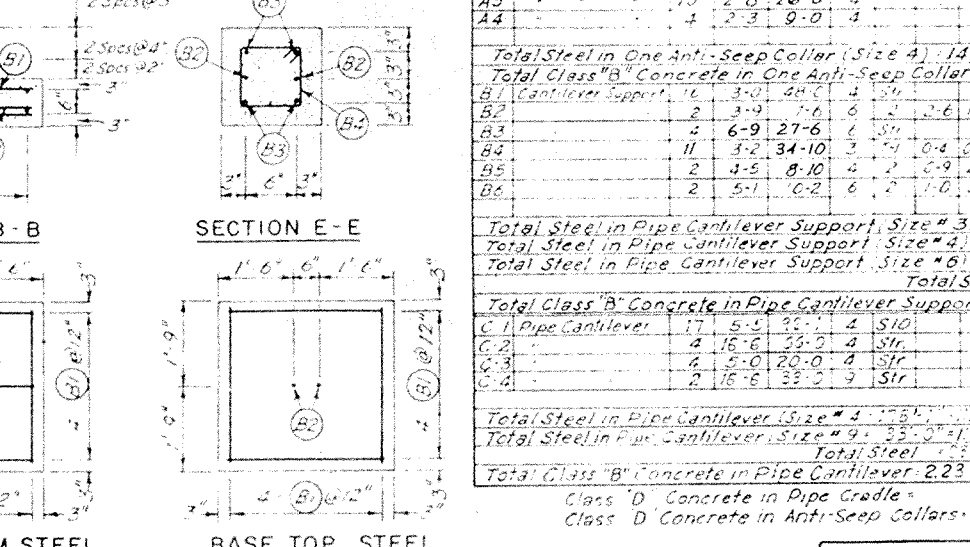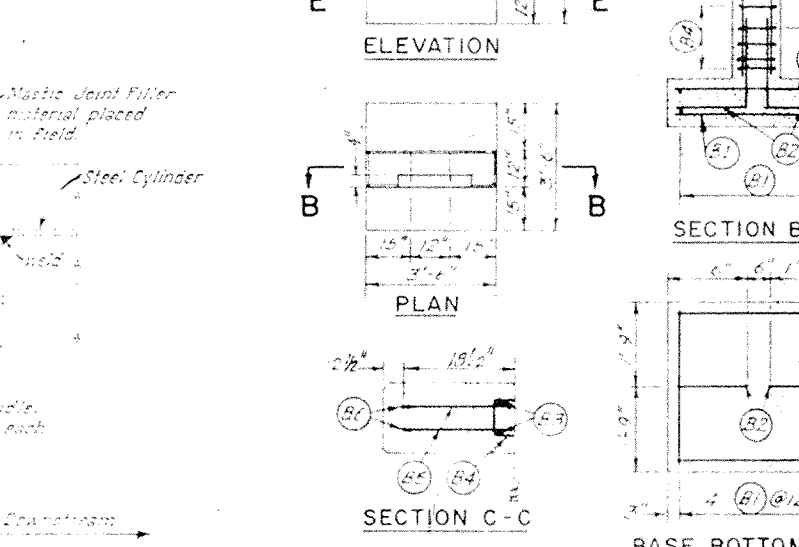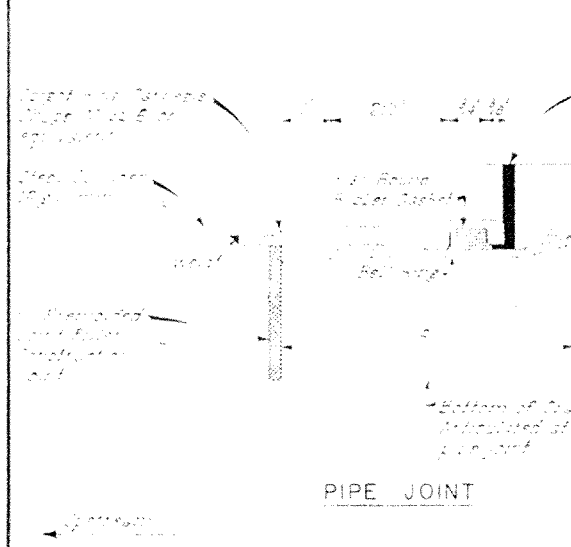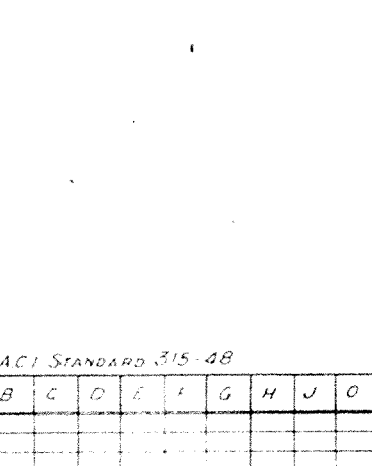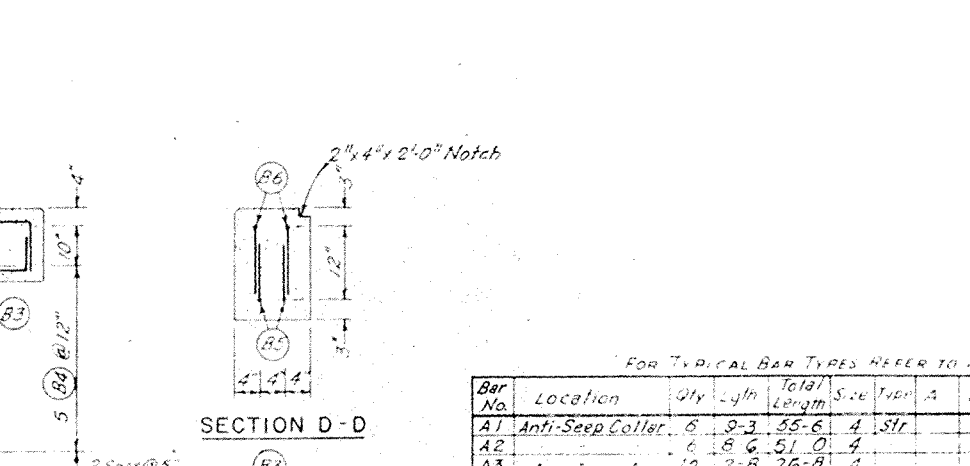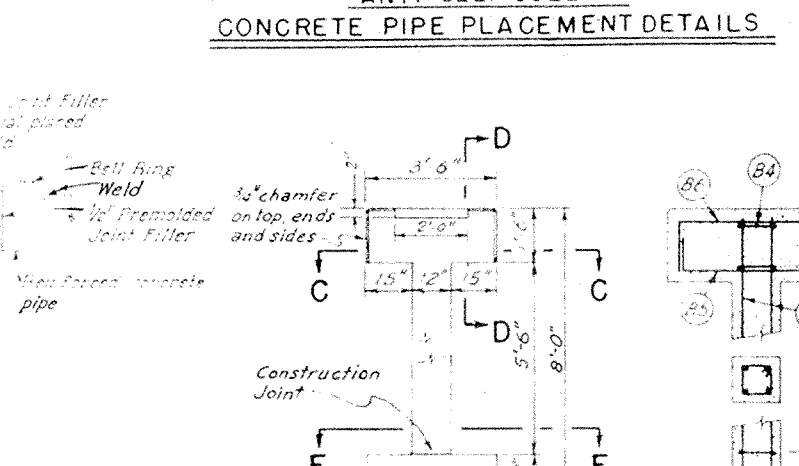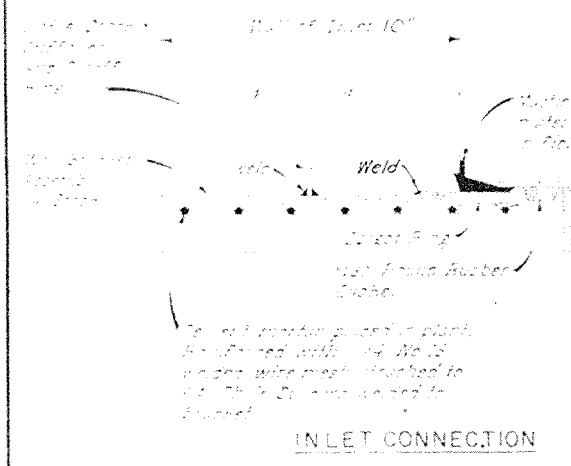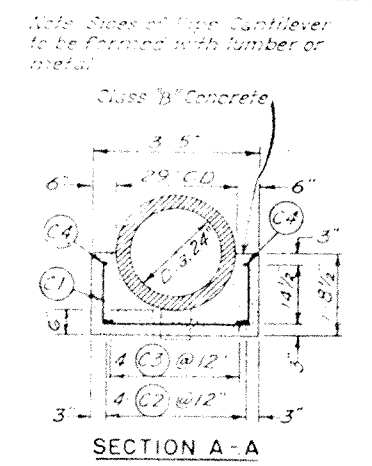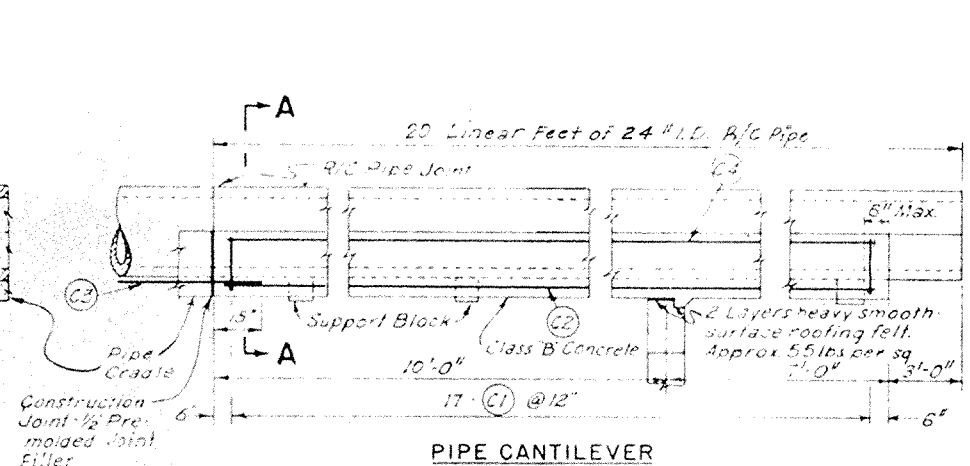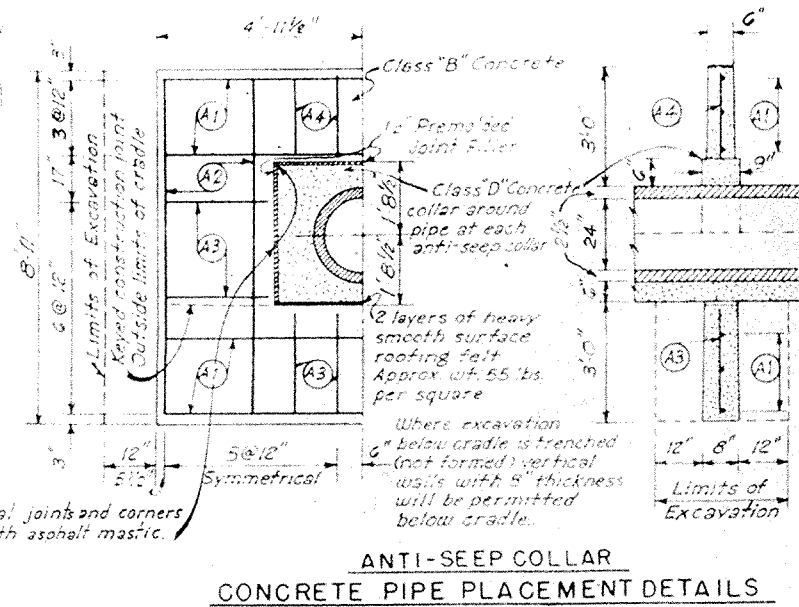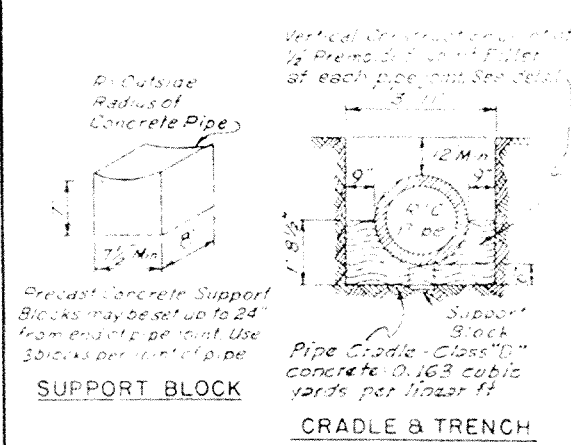

FOR TYPICAL BAR TYPES REFER TO ACI STANDARD 315-48

Bar No.	Location	Qty	Length	Total Length	Size	Type	A	B	C	D	E	F	G	H	J	O
A1	Anti-Seep Collar	6	9-3	55-6	4	Str										
A2		6	8-6	51-0	4											
A3		10	2-8	26-8	4											
A4		4	2-3	9-0	4											
Total Steel in One Anti-Seep Collar (Size # 4) 142'-2" = 94.97 lbs.																
Total Class "B" Concrete in One Anti-Seep Collar = 1.62 cu yds																
B1	Cantilever Support	16	3-0	48-0	4	Str										
B2		2	3-9	7-6	6	Str										
B3		4	6-9	27-6	6	Str										
B4		11	3-2	34-10	3	Str										
B5		2	4-5	8-10	4	Str										
B6		2	5-1	10-2	6	Str										
Total Steel in Pipe Cantilever Support (Size # 3) 34'-10" = 13.10 lbs.																
Total Steel in Pipe Cantilever Support (Size # 4) 56'-10" = 37.96 lbs																
Total Steel in Pipe Cantilever Support (Size # 6) 44'-8" = 67.09 lbs																
Total Steel = 118.15 lbs																
Total Class "B" Concrete in Pipe Cantilever Support = 0.85 cu yds																
C1	Pipe Cantilever	17	5-5	93-5	4	Str										
C2		4	16-6	66-0	4	Str										
C3		4	5-0	20-0	4	Str										
C4		2	16-6	33-2	9	Str										
Total Steel in Pipe Cantilever (Size # 4) 155'-10" = 118.15 lbs																
Total Steel in Pipe Cantilever (Size # 9) 35'-0" = 118.15 lbs																
Total Steel = 118.15 lbs																
Total Class "B" Concrete in Pipe Cantilever = 2.23 cu yds																
Class "D" Concrete in Pipe Cradle = 34.23 Cu Yds																
Class "D" Concrete in Anti-Seep Collars = 0.60 "																
Total Class "D" = 34.83 Cu Yds																

PIPE DETAILS

FLOODWATER RETARDING STRUCTURE SITE NO. 11

PLUM CREEK WATERSHED

IN

HAYS, CALDWELL AND TRAVIS COUNTIES, TEXAS

U. S. DEPARTMENT OF AGRICULTURE

SOIL CONSERVATION SERVICE

Designed **G.J.M.** Date **5-61**

Drawn **G.J.M. & M.G.C.** Date **5-61**

Traced **M.G.C.** Date **5-61**


Checked **G.J.M. & G.W.T.** Date **5-61**

As Built Plan

Construction Completed 11-16-62

Scale 1" = 10'

Sheet 4-E-15,595

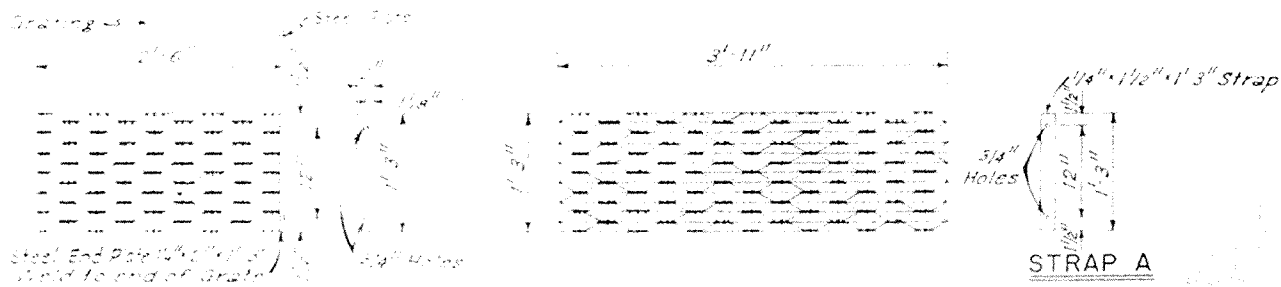

SECTION A
4 Required

GRATING

SECTION B
2 Required

Wall Bracket - Armco Pattern No. B4-006 or equal. Set 5/8" x 1/2" bolts to fit

SIDE VIEW
DEBRIS GUARD

Note: SA, SC, and Aluminum Grating is to be attached to inlet with 5/8" bolts attached through 3/4" galvanized pipe sleeves. Sleeves are to be in place before concrete is placed.

TOP VIEW

Drill or punch 3/4" holes for 5/8" anchor bolts. Cut & weld as shown.

Take 2 Thus Make 2 Opposite Hand Angle B 2" x 2" x 1/4" x 4" Plain 12 Required

1/4" Holes in V of Angle

ANGLE DETAIL

Holes may be drilled or punched

Bolt A - 10" x 1/2" Bolt B - 10" x 1/2" 3/4" Pipe Sleeve

DETAIL A

Bolt A - 6 Required Bolt B - 6 Required

Section A Aluminum Grating Weld End Plate Section A Strap A Lock Washer 5/8" x 2 1/2" Bolt

DETAIL B

Note Bolt grating to & A before welding & B to frame

ORIFICE PLATE DETAIL


SCHEDULE OF QUANTITIES FOR ORIFICE PLATE		
Quantity	Item	Description
4	Angles	2 1/2" x 2 1/2" x 1/4" x 3'-4" Punch & weld
2	Plates	1/4" x 1' 10 1/2" x 3'-4"
2	Bolts & nuts	1/2" x 3/4" Machine (galv.)
4	Bolts & nuts	1/2" x 1/2" Machine (galv.)

8" Dia. Slide Gate, bronze mounted, spigot back, Armco 50-10c or equivalent, with stem, stem guides and handwheel. Lift Type H-10, 76" Stem Dia.

SCHEDULE OF QUANTITIES FOR TRASH GUARD		
Quantity	Item	Description
4	4 A	2' x 2' x 1/4" x 9'-0" Cut, weld & punch
10	4 B	2' x 2' x 1/4" x 5'-0" Plain
6	4 C	2' x 2' x 1/4" x 5'-0" Punch as shown
4	Strap A	1/4" x 1 1/2" x 1'-3" Punch as shown
4	Grating Sec A	1'-3" x 2'-6" As detailed
2	Grating Sec B	1'-3" x 3'-11" As detailed
6	Bolts & nuts	5/8" As detailed
6	Bolts & nuts	5/8" As detailed
8	Bolts	5/8" x 2 1/2" Machine (galv.)
22	Bolts	5/8" x 9 1/2" Machine (galv.)
10	Bolts	5/8" x 11 1/2" Machine (galv.)

10	Lock Washers	1/2"
40	Lock Washers	5/8"
4	Flat Washers	1/2"
56	Flat Washers	5/8"
28	Pipe Sleeves	3/4" x 8" (Galv.)
16	Pipe Sleeves	3/4" x 10" (Galv.)

All pipe sleeves, nuts, bolts and washers to be galvanized unless otherwise specified.

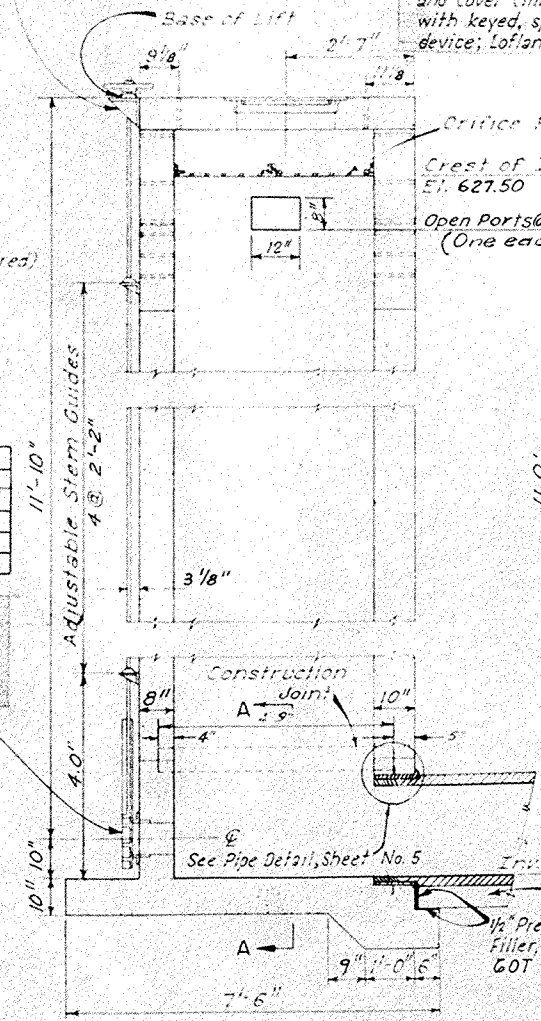

SECTION

HALF PLAN - BASE

NOTE: Manhole ring and cover not a bid item; to be included in cost of inlet

Construction Joint 1/4" x 6" x 14'-10" steel plate continuous around inlet


SECTIONAL ELEVATION

PRINCIPAL SPILLWAY - INLET
FLOODWATER RETARDING STRUCTURE SITE No. 1
PLUM CREEK WATERSHED
IN
HAYS, CALDWELL AND TRAVIS COUNTIES, TEXA

U. S. DEPARTMENT OF AGRICULTURE
SOIL CONSERVATION SERVICE

Designed G.J.M. 5-61
Drawn G.J.M. & M.G.C. 5-61
Traced M.G.C. 5-61
Checked G.J.M. & G.W.T. 5-61

Date 5-61
Approved by [Signature]
STATE CONSERVATION ENGINEER
TEMP. [Signature]
No. 6
4-E-15, 59

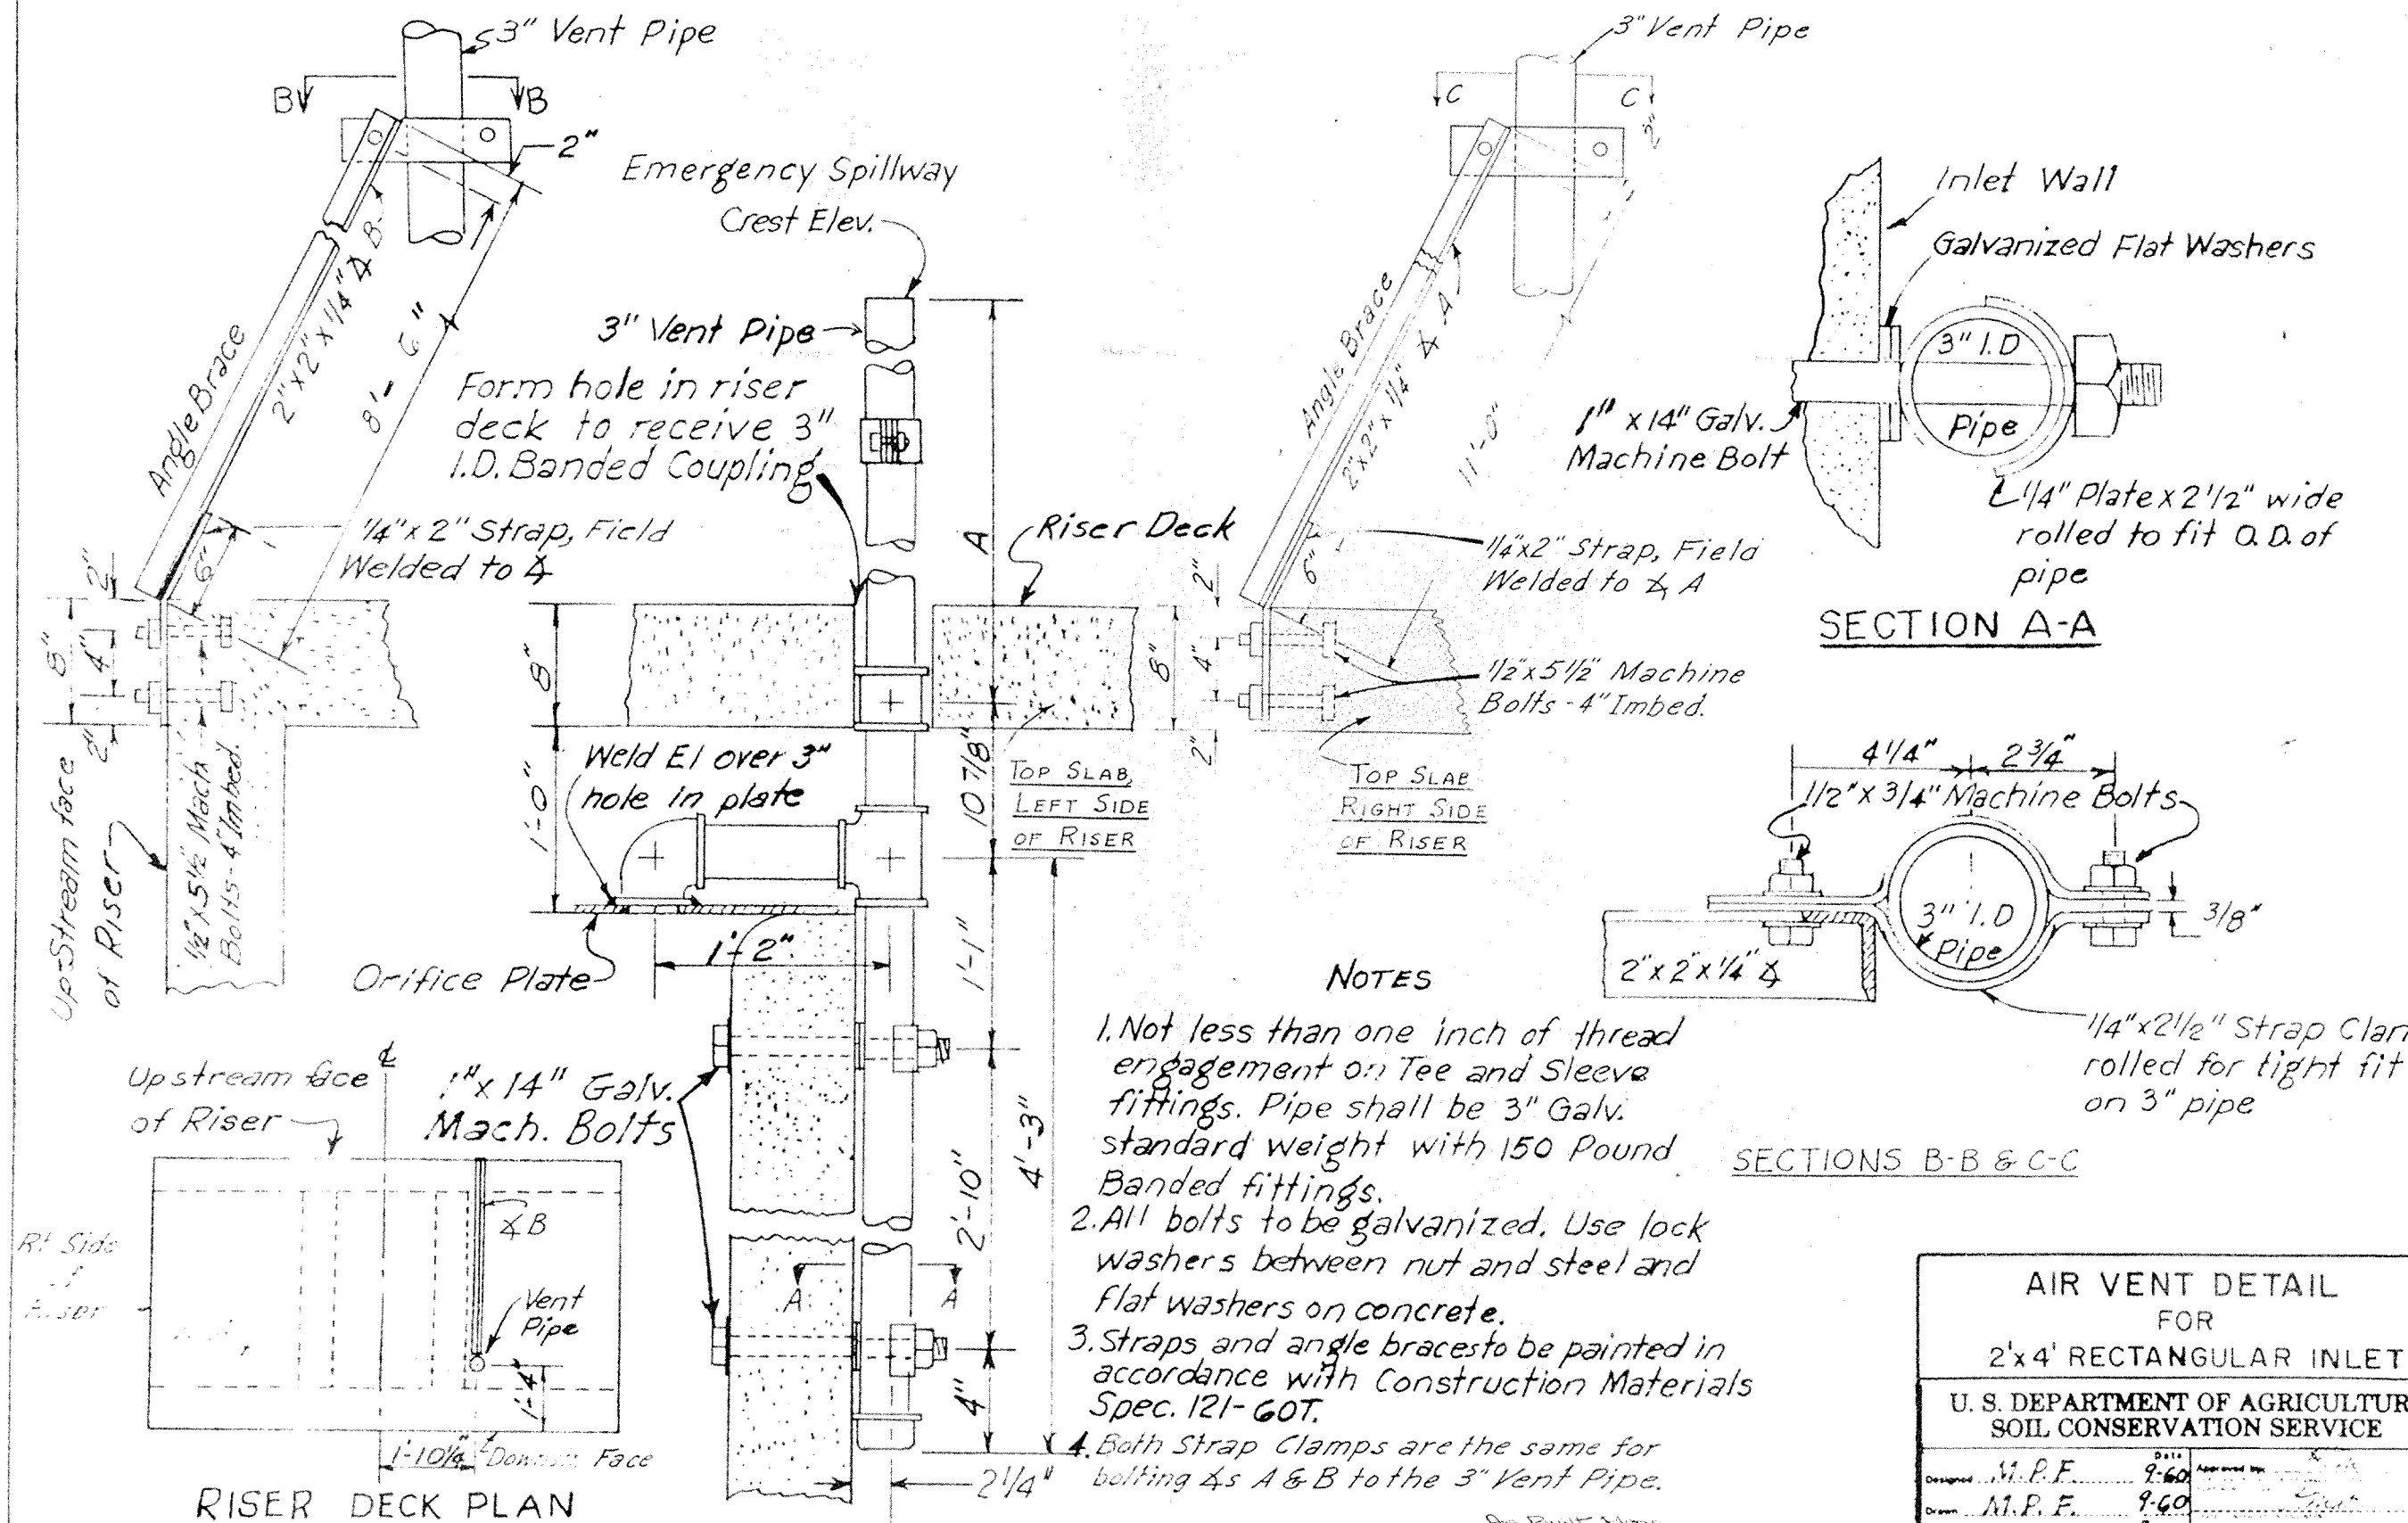


AIR VENT DETAIL FOR 2'x4' RECTANGULAR INLET			
U. S. DEPARTMENT OF AGRICULTURE SOIL CONSERVATION SERVICE			
Designed	M.P.F.	9-60	Approved by
Drawn	M.P.F.	9-60	Checked
Traced	M.P.F.	9-60	Sheet
Checked	M.P.F.	9-60	No. 7
			Drawing No.
			4-E-15,595

FOR TYPICAL BAR TYPES REFER TO A.C.I. STANDARDS 815-48


No.	Qty	Lgth	Total Lgth	Size	Type	A	B	C	D	G	J	O	No.	Qty	Lgth	Total Lgth	Size	Type	A	B	C	D	S
1	5	5'-0"	25'-0"	5	See Detail								18	18	8'-1"	145'-6"	4	2	1'-0"	4'-5"			
2	9	6'-10"	61'-0"	5	Str.								19	18	9'-6"	171'-0"	4	2	2'-2"	5'-2"			
3	2	3'-2"	6'-4"	5	Str.								20	22	9'-0"	198'-0"	4	Str.					
4	9	7'-0"	63'-0"	5	Str.								21	4	5'-7"	22'-4"	4	2	2'-4"	3'-3"			
5	6	5'-6"	33'-0"	5	2	1'-6"	4'-0"						22	4	6'-3"	25'-0"	4	2	3'-0"	3'-3"			
6	14	6'-0"	84'-0"	5	2	2'-0"	4'-0"						23	4	5'-10"	27'-4"	4	2	3'-7"	3'-3"			
7	4	8'-9"	35'-0"	5	2	4'-9"	4'-0"						24	8	4'-5"	35'-4"	4	2	1'-2"	3'-3"			
8	10	6'-0"	60'-0"	5	2	2'-0"	4'-0"						25	2	2'-11"	5'-10"	4	2	1'-2"	1'-9"			
9	6	6'-10"	41'-0"	5	Str.								26	2	2'-7"	5'-2"	4	2	1'-2"	1'-5"			
10	2	7'-0"	14'-0"	5	Str.								27	4	4'-0"	16'-0"	4	2	1'-2"	2'-10"			
11	9	6'-9"	54'-0"	5	2	2'-0"	4'-9"						28	4	6'-1"	24'-4"	4	2	3'-3"	2'-10"			
13	2	7'-6"	60'-0"	5	2	2'-4"	5'-2"						29	4	5'-6"	22'-0"	4	2	2'-8"	2'-10"			
16	16	8'-4"	133'-4"	4	Str.								30	4	4'-10"	19'-4"	4	2	2'-0"	2'-10"			
17	20	9'-4"	186'-8"	4	Str.								31	2	2'-7"	5'-2"	4	2	1'-2"	1'-5"			
													32	4	3'-6"	14'-0"	4	Str.					
													33	2	2'-2"	4'-4"	4	2	1'-2"	1'-0"			
													34	8	4'-0"	32'-0"	4	Str.					

Total Size 4 Steel in Prin Spwy Inlet = 1092'-6" = 7.
Total Size 5 Steel " " " = 536'-10" = 5.
Total Steel in Prin Spwy Inlet = 128.
Total Class "B" Conc in Prin Spwy Inlet = 8.2


Note: Shift bars 16, 18 & 19 to clear open ports. See Sheet No. 6

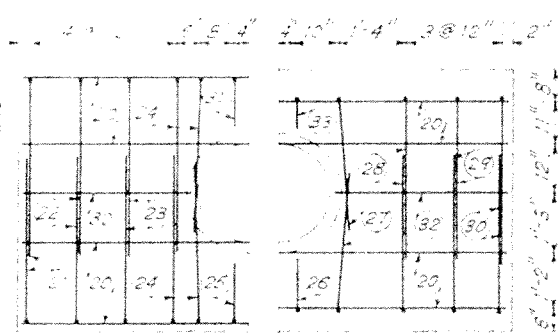


TOP
BOTTOM
PLAN
ANTI-VORTEX DECK

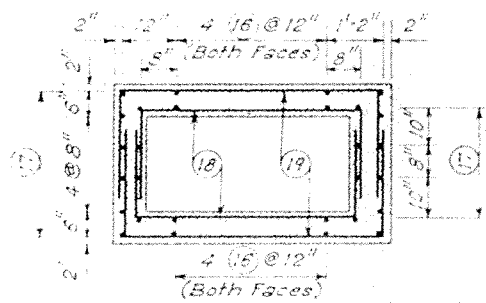


SECTION A-A

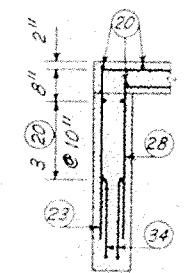


SECTION B-B

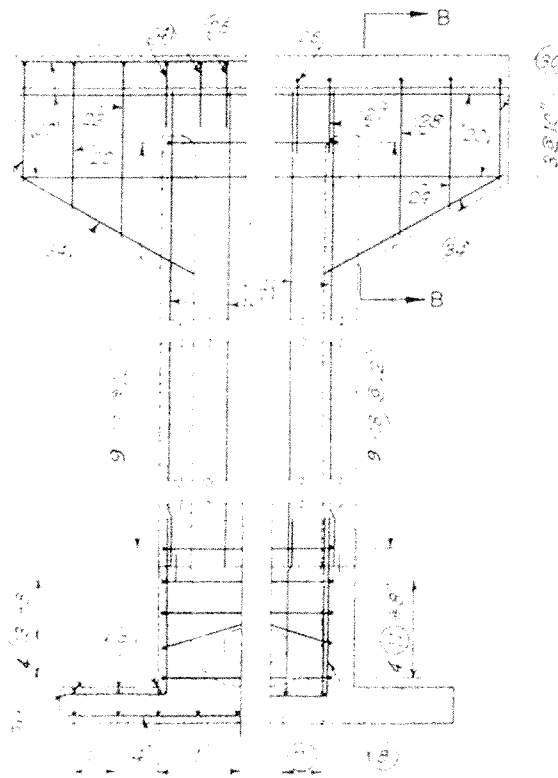

OUTSIDE INSIDE
HALF SECTIONS
(UPSTREAM)

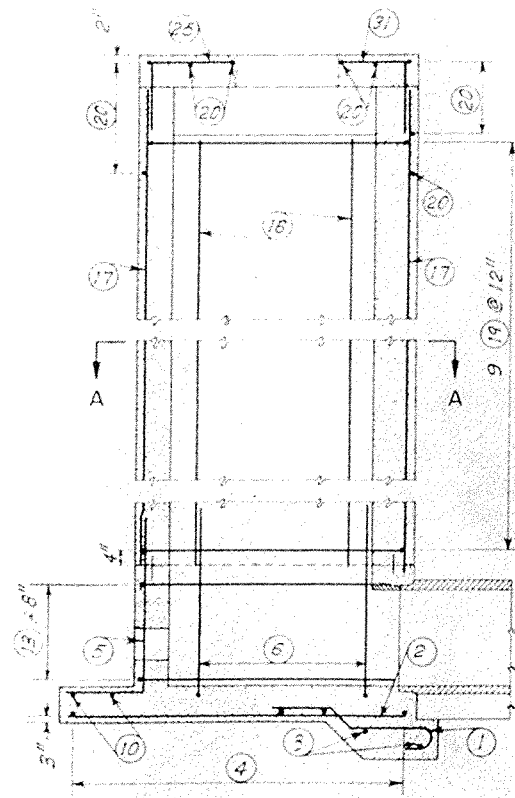


SECTION ALONG C

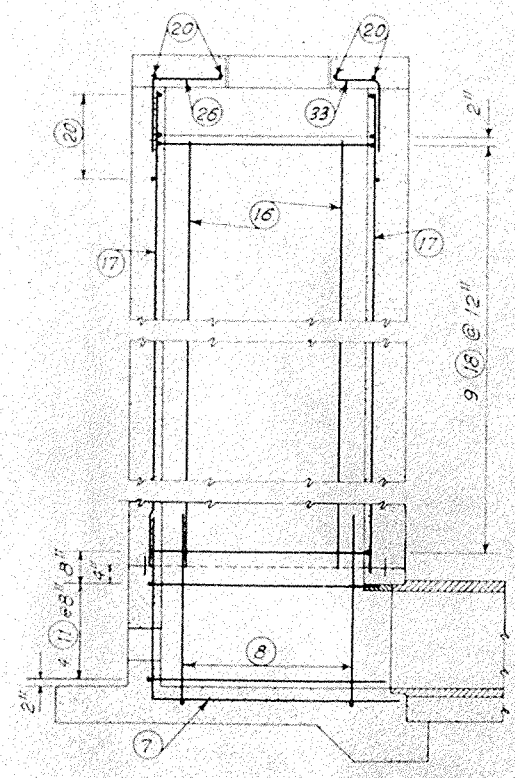



OUTSIDE INSIDE
HALF SECTIONS
(DOWNSTREAM)

Note: All steel to have a minimum of 2" cover from exposed surfaces, unless otherwise specified.

As Built Plans
Construction Completed 4-16-62

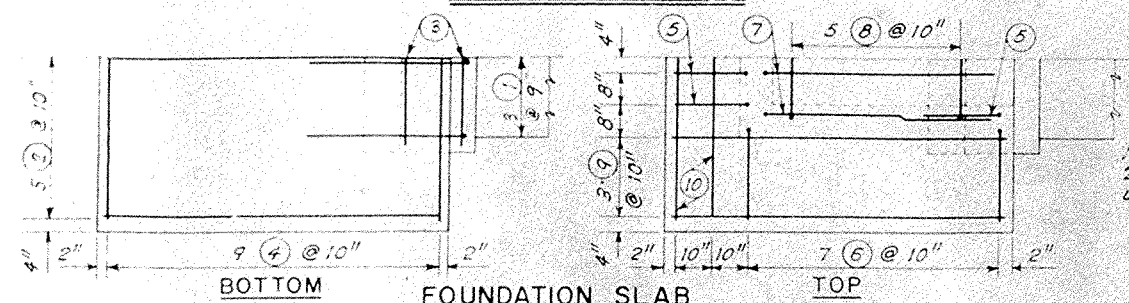

FOUNDATION SLAB
TOP

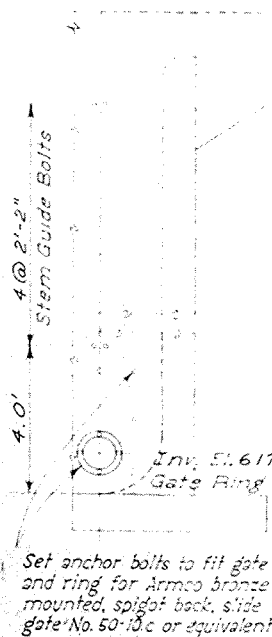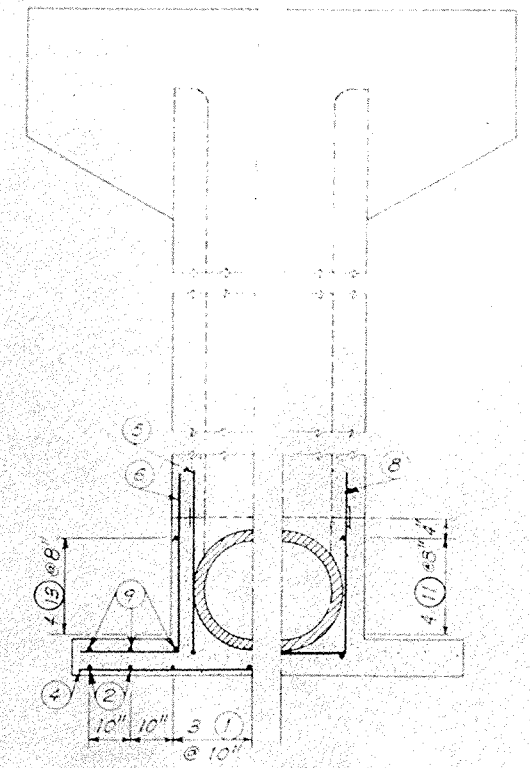


Set anchor bolts to fit gate and ring for Armo bronze mounted, spigot back, slide gate No. 50-10.c or equivalent.

SLIDE GATE


STEEL PLACEMENT - PRINCIPAL SPILLWAY FLOODWATER RETARDING STRUCTURE SITE NO PLUM CREEK WATERSHED IN HAYS, CALDWELL AND TRAVIS COUNTIES, TEXAS			
U. S. DEPARTMENT OF AGRICULTURE SOIL CONSERVATION SERVICE			
Designed	G.J.M.	Date	5-61
Drawn	G.J.M. & M.G.C.	5-61	Approved By STATE CONSERVATION ENGINEER'S OFFICE TEMPLE, TEXAS
Traced	M.G.C.	5-61	Sheet Drawing No
Checked	G.J.M. & G.W.T.	5-61	No 8 of 9
			4-E-15, 5

Note: Wire stays to be 10 ga. (min. size), galv. two strand spiral, twist-on type. Length to extend from top fence strand to 8" below bottom fence strand for barbed wire fences and from top strand to 8" below the second strand of the woven wire for woven wire fences. Wire stays to be spaced equally, two stays per line post panel. Stays to be twisted firmly against top strand.

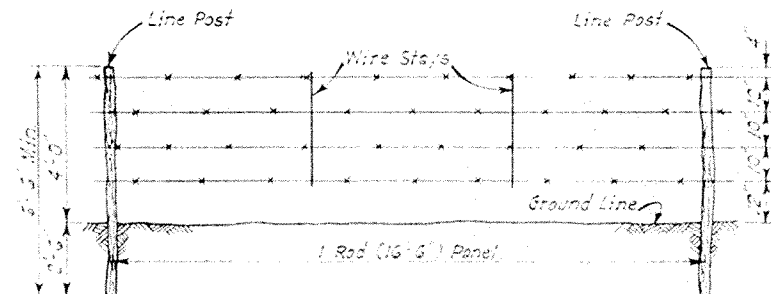

BARBED WIRE

Barbed wire to be 10th ga. galv. double strand barbed wire with 14 ga. point bars at 4 ft. Staples to be 9 ga. galv. 1/2" minimum length for treated pine and cedar posts and 1" minimum length for bolts and rods.

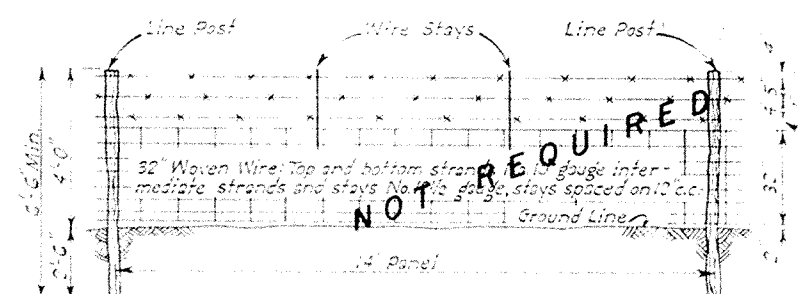


WOVEN WIRE

Minimum Post Size

Corner & Brace	Cedar, 8" dia. Treated Pine, 5" dia. Bolt & rod, 5" dia.
Line Posts	Cedar, 4" dia. Treated Pine, 5" dia. Bolt & rod, 5" dia. Other, see specifications
Gate Posts	Treated Pine, 5" dia.

Note: Ash Juniper is considered as meeting the requirements of the specifications for cedar posts. Creosote-Jol-Ten Solution will be used for treatment of pine posts.

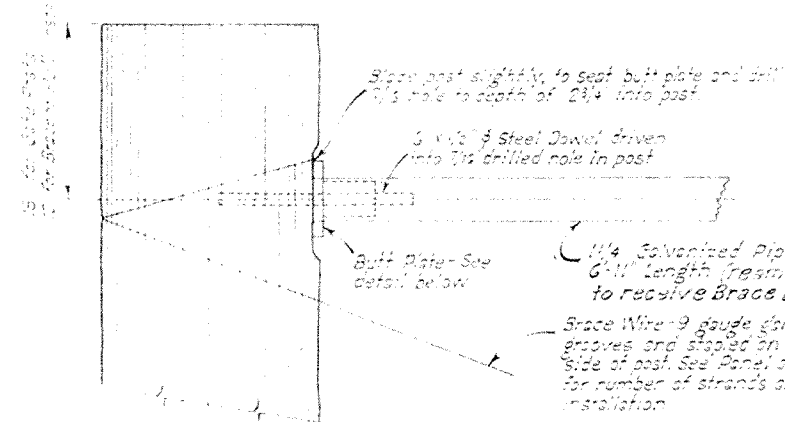


POST DETAIL

Top Line, End, Brace & Gate Posts




BRACE BUTT PLATE

Brace Butt Plate of plate steel 2" x 1/2" x 8". 2" dia hole drilled in center, with 1/2" x 1/2" x 8" steel jawel plate, 1/2" long, welded to plate. Weld to be inside of plate with one longitudinal corner with the 1/2" drilled hole in the plate.

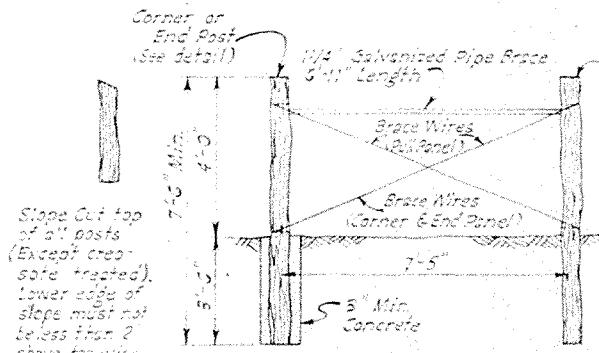

CORNER, END, OR PULL PANEL


Pull panel does not require concrete setting. Brace wires for Pull Panel will be two strands from top of each post to bottom of other brace wires for corner and end panels will be four strands from top of brace post to bottom of corner or end post.

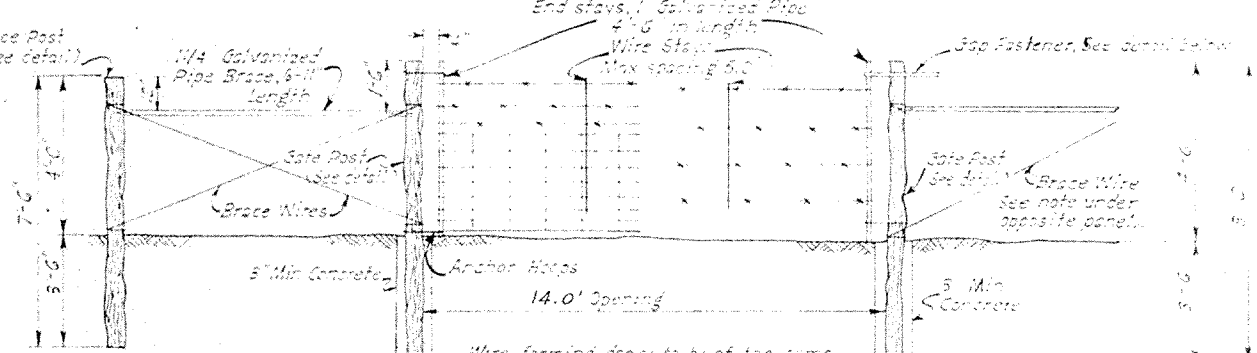

WIRE GAP PANEL

Where fence extends in line left or right of Gate Panel's brace wires for Gate Panel will be four strands from top of Brace Post to bottom of Gate Post. Where there is no pull of line fence (that is, the Gate Panel is at a corner), Brace Wires for the Gate Panel will be two strands from top of each post to bottom of other.

Wire forming gaps to be of the same type and spacing as the regular fence. Wire to be double wrapped around end stays and secured in place by drilling 1/4" holes at bottom and top strands of woven wire and at each strand of barbed wire. Tying these strands with 14 gauge galvanized wire through the holes. Anchor hoops to be two strands of 9 gauge wire stapled at the back side of the gate post. 2 - Staples required.

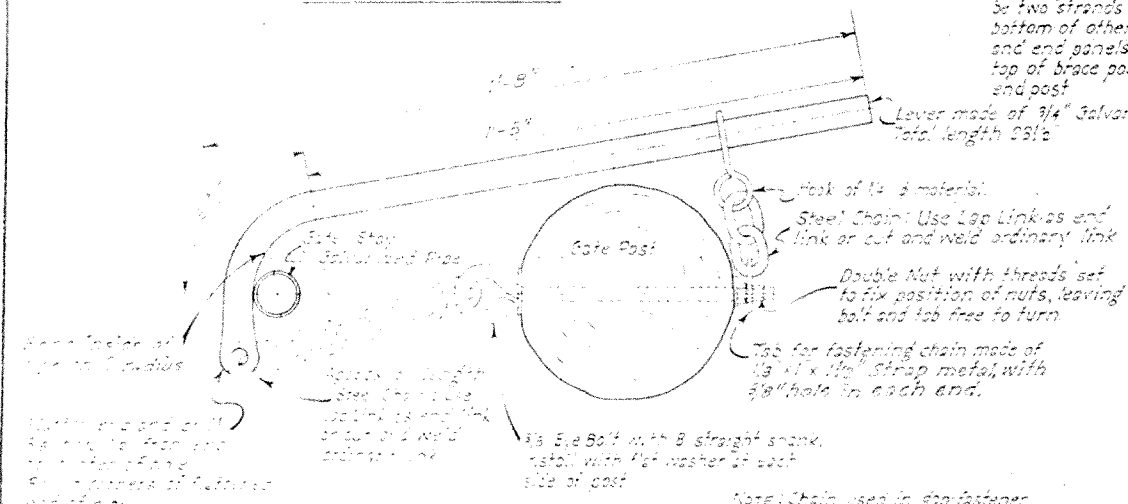

WIRE GAP FASTENER DETAIL

Note: Chain used in gap fastener may be either straight link or twist link (twist material size from 1/8" to 1/2", links per foot from 10 to 18, wt. per foot from 0.1 to 0.5 lbs. Weldless wire twist chain will not be permitted).

FENCE DETAILS

As Built Plans
Construction Completed 4-16-62

FENCE DETAILS			
FLOODWATER RETARDING STRUCTURE SITE No 11			
PLUM CREEK WATERSHED			
IN			
HAYS, CALDWELL AND TRAVIS COUNTIES, TEXAS			
U. S. DEPARTMENT OF AGRICULTURE			
SOIL CONSERVATION SERVICE			
Designed	G. J. M.	Date	5-61
Drawn	G. J. M. & M. G. C.	Date	5-61
Traced	M. G. C.	Date	5-61
Checked	G. J. M. & G. W. T.	Date	5-61
Sheet		Drawing No.	
No 9		4 - E - 15,595	