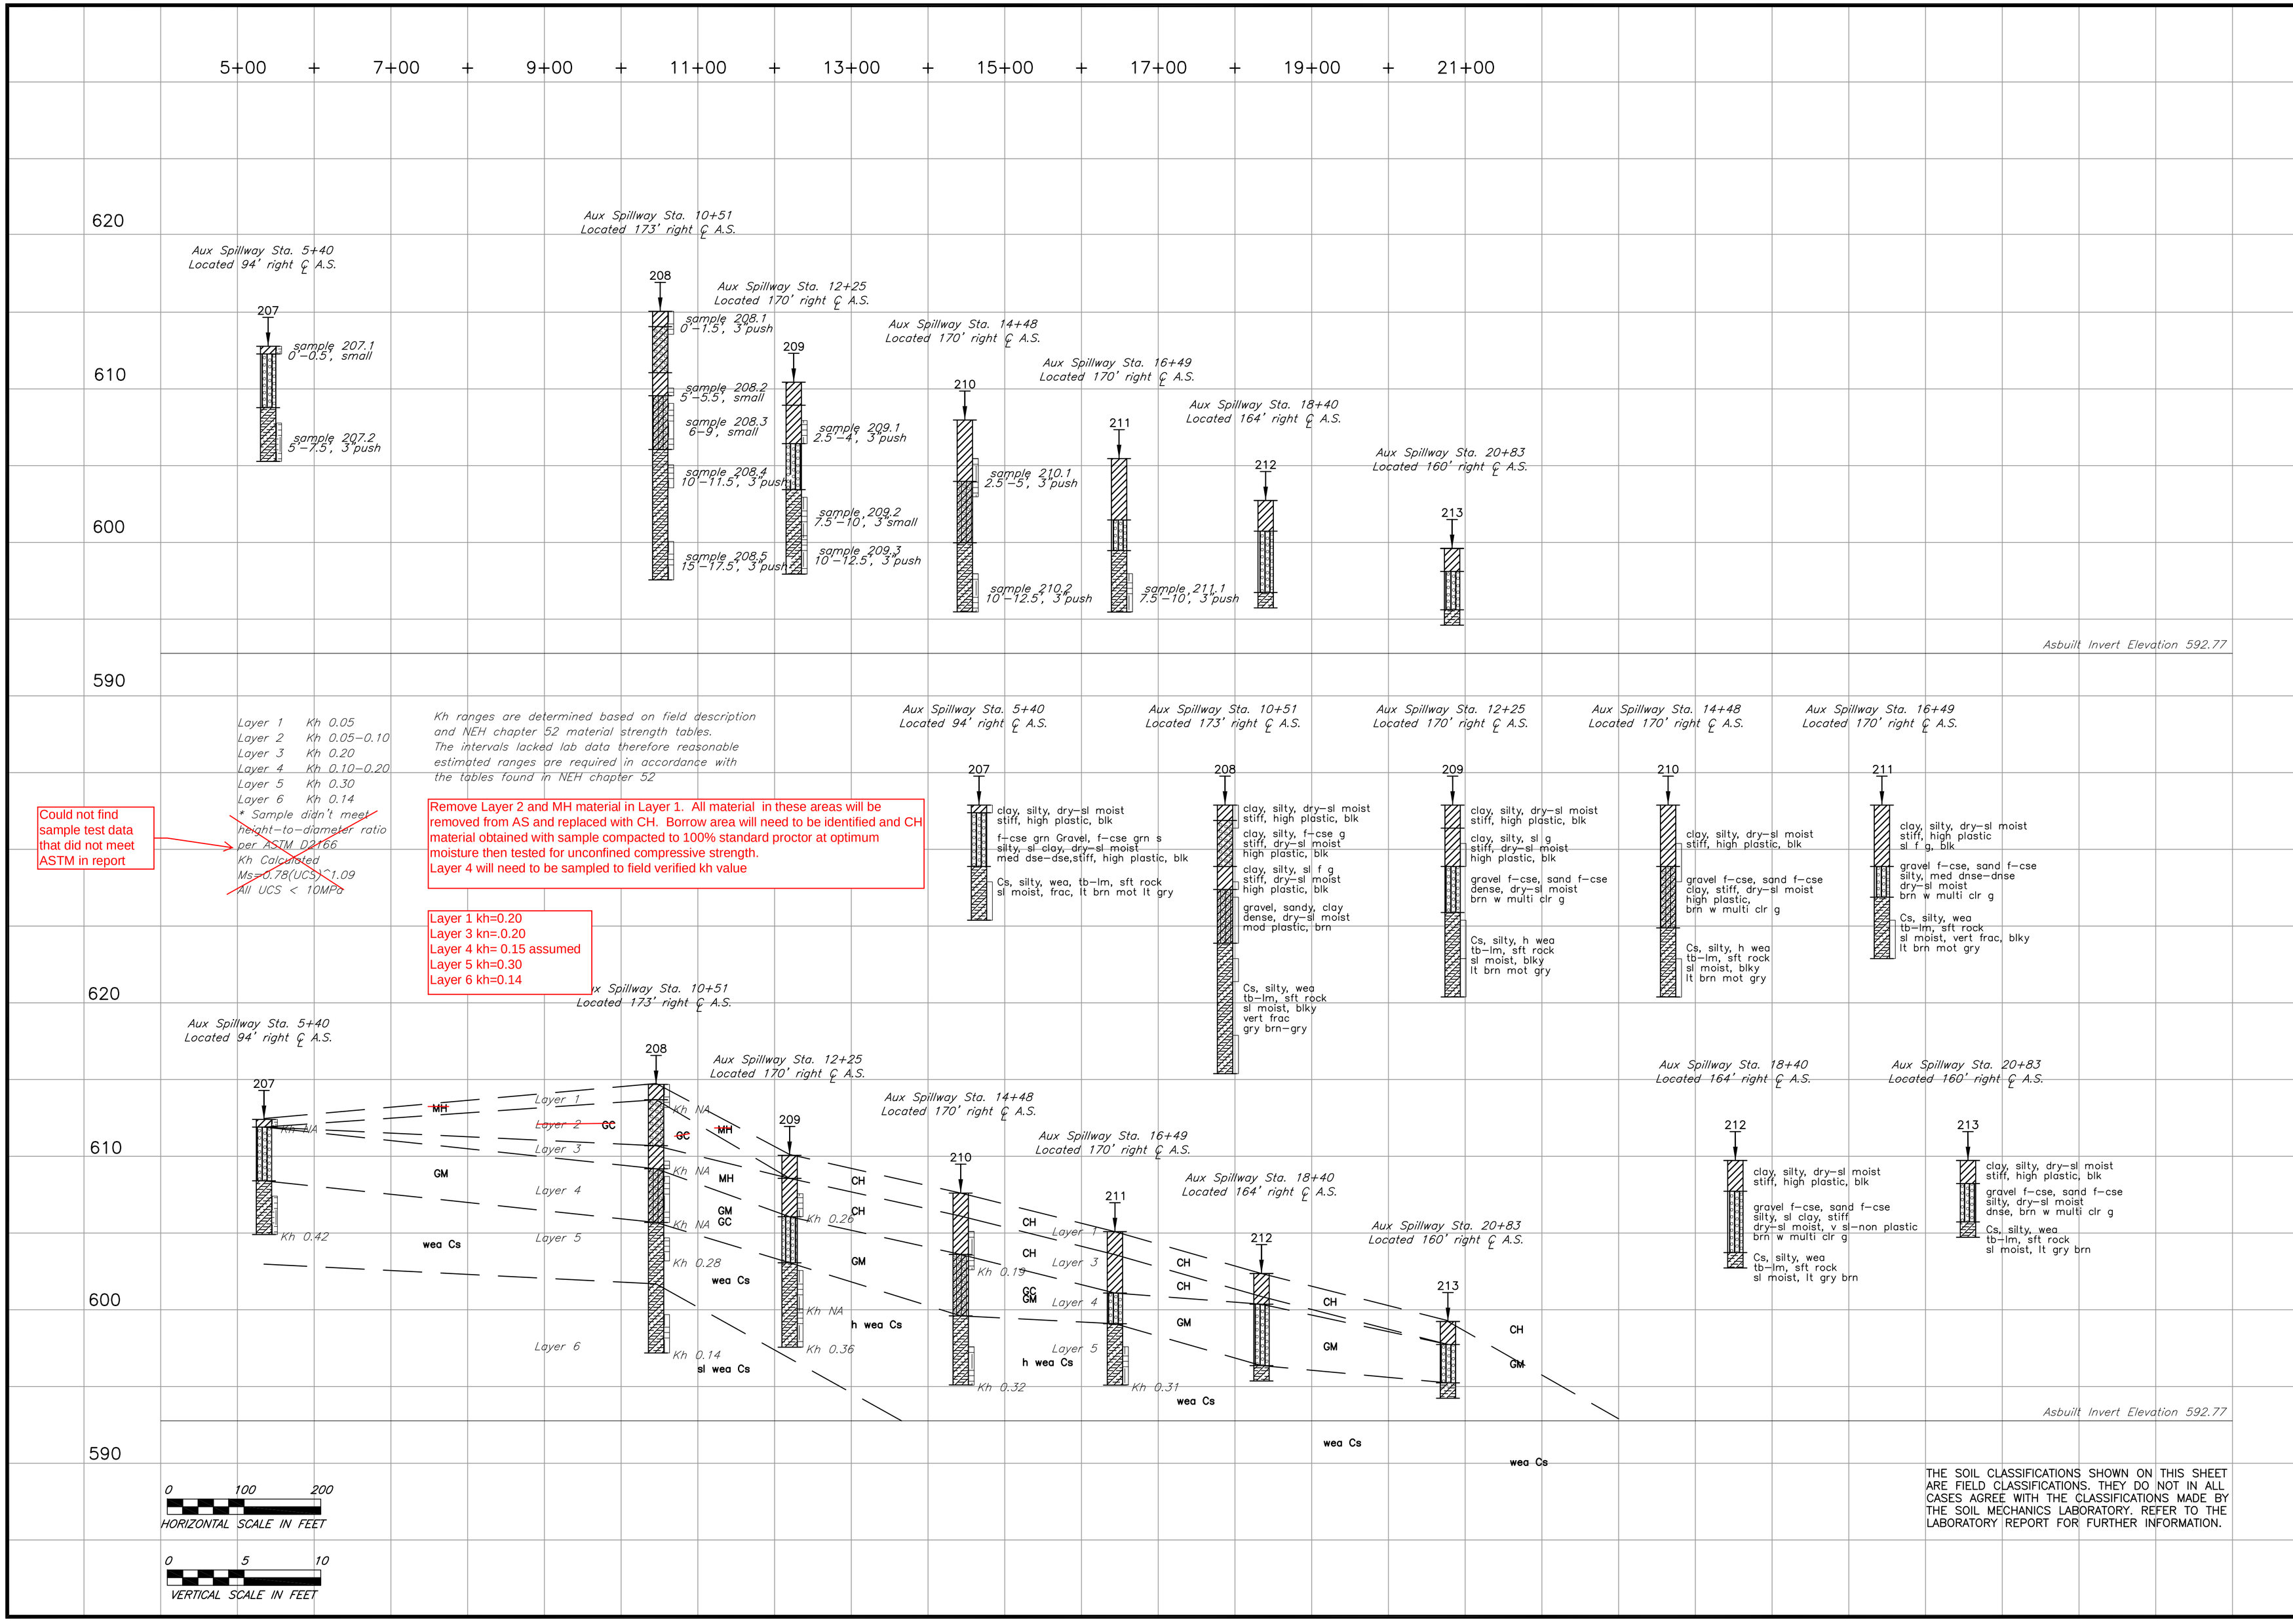

THE SOIL CLASSIFICATIONS SHOWN ON THIS SHEET ARE FIELD CLASSIFICATIONS. THEY DO NOT IN ALL CASES AGREE WITH THE CLASSIFICATIONS MADE BY THE SOIL MECHANICS LABORATORY. REFER TO THE LABORATORY REPORT FOR FURTHER INFORMATION.

This document is released for the purpose of interim review and mark-up under the authority of John W. Mueller, P.E. 90026 on May 28, 2015. It is not to be used for construction, bidding, permit, or contracting purposes.

INVESTIGATED BY: BRYAN M. & DANIEL W.
TITLE: GEOLOGIST
PLOTTED BY: DANIEL WILKINSON
FILE NAME: Plum Creek 12 Auxiliary Spillway Profile.dwg
DATE PLOTTED: May 28, 2015

PLAN AND PROFILES FOR GEOLOGIC INVESTIGATIONS
FLOODWATER RETARDING STRUCTURE SITE NO. 12
PLUM CREEK WATERSHED
OF THE
COLORADO RIVER WATERSHED – TEXAS

United States Department of Agriculture
Natural Resources Conservation Service

REVISIONS	DATE

DRAWING NO. TX–EN–####
SHEET ####

D:\Rehab Dams\Plum Creek 12\Plum Creek 12 Auxiliary Spillway Profile.dwg